



SUITE 107 | 201 CAMP ROAD

Total: 25,399 RSF


Level 1 : 18,869 RSF | Mezzanine: 6,530 RSF

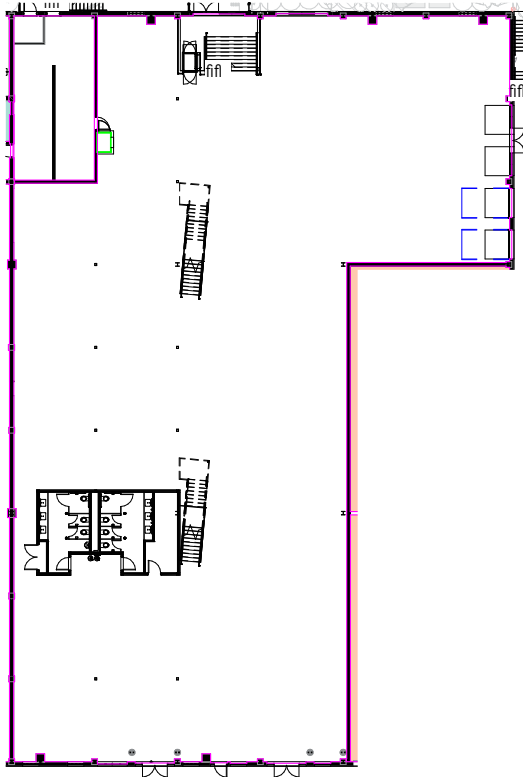

Level 1

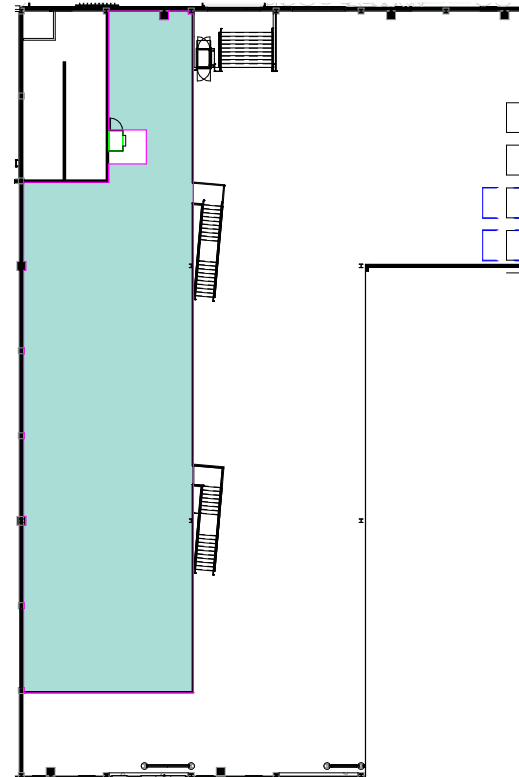

Mezzanine

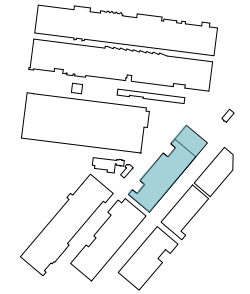

CONTACT

RHEA GREENE | 704.928.5211 | rdg@trinity-partners.com
JENNIFER KURZ | 704.576.2254 | jtk@trinity-partners.com
CHASE MERKEL | 410.693.8745 | cmerkel@trinity-partners.com



WWW.CAMP.NC

DEVELOPED AND OWNED BY:

