
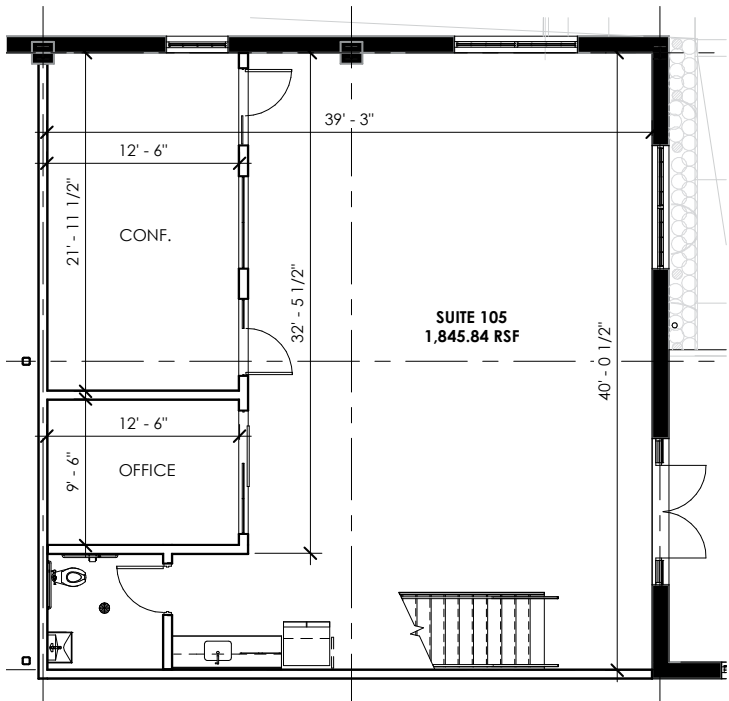



# SUITE 105 | 201 CAMP ROAD

Total: 2,463 RSF

Level 1 : 1,846 RSF | Mezzanine: 616 RSF

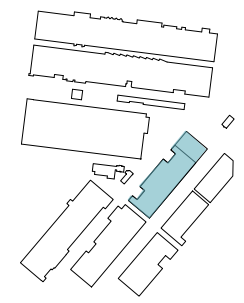

Level 1

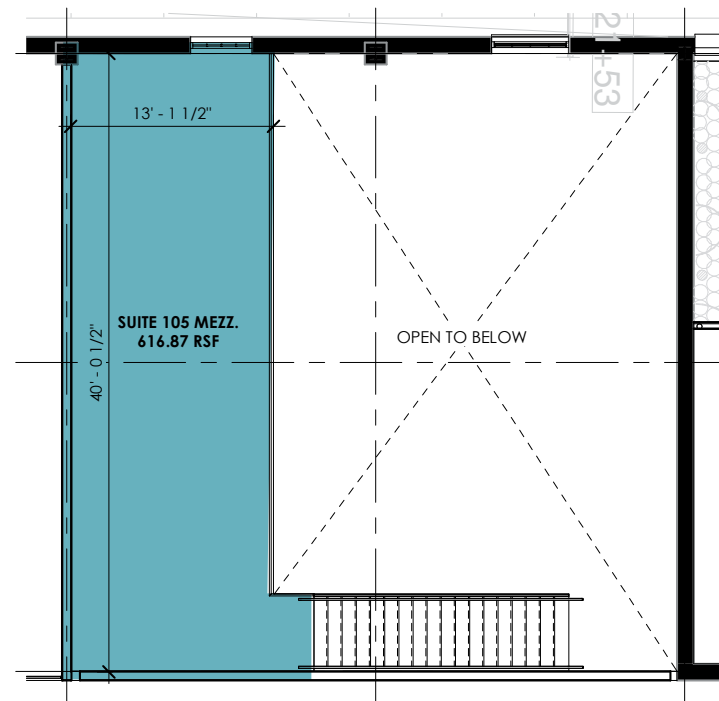

Mezzanine

## CONTACT

RHEA GREENE | 704.928.5211 | [rdg@trinity-partners.com](mailto:rdg@trinity-partners.com)

JENNIFER KURZ | 704.576.2254 | [jtk@trinity-partners.com](mailto:jtk@trinity-partners.com)

CHASE MERKEL | 410.693.8745 | [cmerkel@trinity-partners.com](mailto:cmerkel@trinity-partners.com)



[WWW.CAMP.NC](http://WWW.CAMP.NC)

DEVELOPED AND OWNED BY:

