
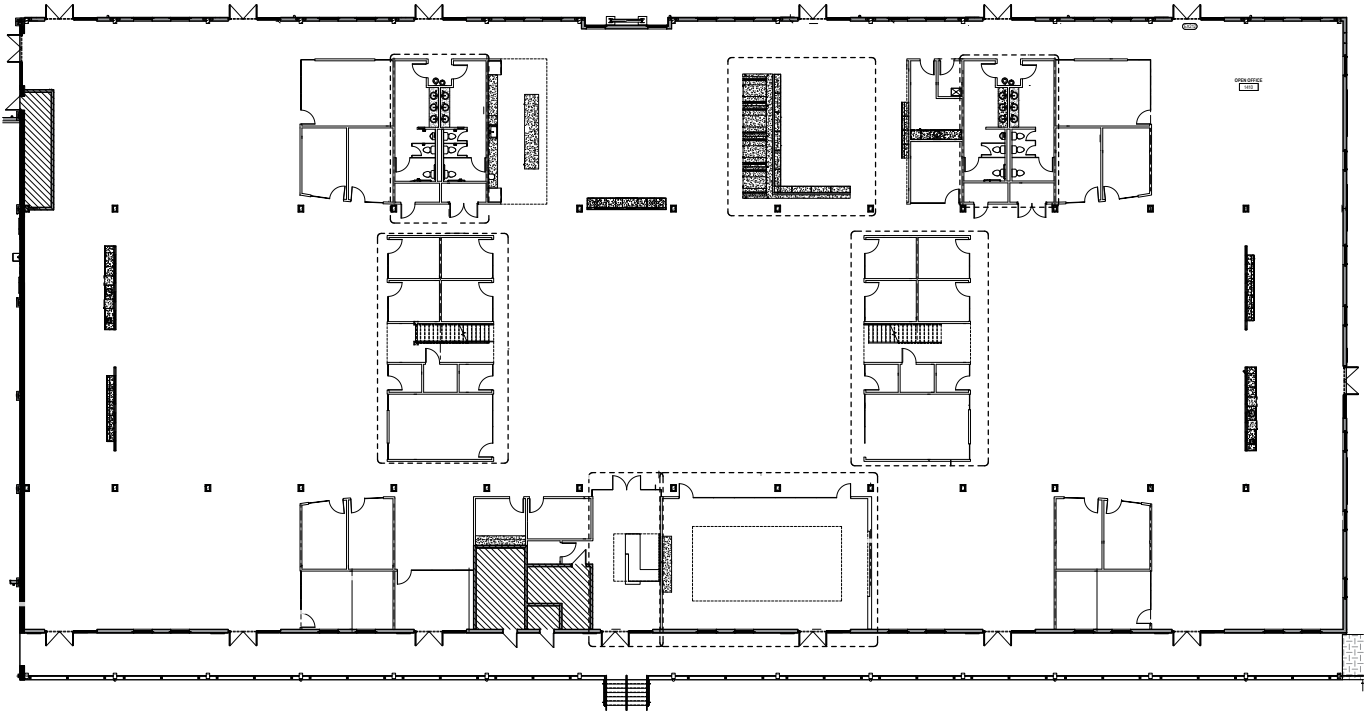


# SUITE 200 | GAMA GOAT

LEVEL 1: 45,434 RSF

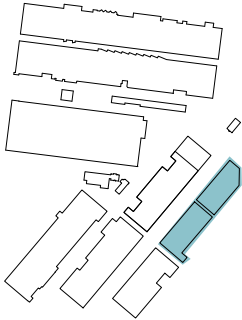

## CONTACT

RHEA GREENE | 704.928.5211 | [rdg@trinity-partners.com](mailto:rdg@trinity-partners.com)  
JENNIFER KURZ | 704.576.2254 | [jtk@trinity-partners.com](mailto:jtk@trinity-partners.com)  
CHASE MERKEL | 410.693.8745 | [cmerkel@trinity-partners.com](mailto:cmerkel@trinity-partners.com)



[WWW.CAMP.NC](http://WWW.CAMP.NC)

DEVELOPED AND OWNED BY:

